ATTACHMENT 6

NAISHO OMAKASE

3033 BRISTOL ST, SUITE 117,
COSTA MESA, CA 92626

FOR INTERIOR TENANT IMPROVEMENT ONLY

PROJECT DATA

BUILDING DEPARTMENT:	CITY OF COSTA MESA
BUILDING CODES:	2022 CALIFORNIA BUILDING CODE 2022 CALIFORNIA ELECTRICAL CODE 2022 CALIFORNIA MECHANICAL CODE 2022 CALIFORNIA PLUMBING CODE 2022 CALIFORNIA FIRE CODE TITLE 24 (ADA) CALIF. ADMINISTRATIVE CODE
APN:	41813107
OCCUPANCY CLASSIFICATION:	PER CBC CHAPTER 3 (TABLE 3A): B - BUSINESS
TYPE OF CONSTRUCTION:	PER CBC CHAPTER 6 (TABLE 6A) - VB
SPRINKLERED:	NO
NUMBER OF STORIES:	1
PROJECT SCOPE:	THE SCOPE OF THIS PROJECT IS THE INTERIOR TENANT IMPROVEMENT OF AN EXISTING SUITE IN A BUILDING.
TENANT OCCUPANCY:	B - BUSINESS
TENANT SQUARE FOOTAGE:	1,422 S.F.
DEFERRED SUBMITTAL:	BUILDING EXTERIOR SIGNAGE

TENANT

NAISHO OMAKASE
3033 BRISTOL ST, SUITE 117
COSTA MESA, CA 92626

SHAUN ITO
949.436.4349 / SHAUN@NAISHOOMAKASE.COM

DESIGNER / ARCHITECT

KING KONG DESIGN + CONSTRUCTION
9295 RESEARCH DR.
IRVINE, CA 92618

JIMMY JAMES
949.466.3878 / JIMMY@KINGKONGDS.COM

MANAGEMENT

EMERALD PROPERTY GROUP
P.O. BOX 125,
CARDIFF, CA 92007

JASON BALL
310.755.5262

SHEET INDEX

ARCHITECTURAL

A0.1	COVER SHEET
A0.2a	GENERAL NOTES
A0.2b	ADDITIONAL PROJECT NOTES
A0.2c	CALIFORNIA GREEN BUILDING CODE
A0.2d	CALIFORNIA GREEN BUILDING CODE
A0.2e	CALIFORNIA GREEN BUILDING CODE
A0.2f	CALIFORNIA GREEN BUILDING CODE
A0.3a	ACCESSIBILITY NOTES
A0.3b	ADDITIONAL ACCESSIBILITY NOTES
A0.3c	ENLARGED RESTROOM
A1.0	SITE PLAN
A1.1	SITE DETAILS
A1.2	EXIT PLAN
A1.3	OCCUPANCY PLAN
A2.0	DEMOLITION PLAN
A2.1	PARTITION PLAN
A3.1	POWER, WATER & DATA PLAN
A3.2	EQUIPMENT PLAN
A4.1	REFLECTED CEILING PLAN
A5.1	FINISH PLAN
A6.1	ELEVATIONS - BAR 101
A6.2	ELEVATIONS - DINING 105
A6.3	ELEVATIONS - SERVICE 104
A6.4	MILLWORK DRAWING - SERVICE 104
A6.5	MILLWORK DRAWING - BAR 101
A7.1	DOOR SCHEDULE
A8.1	WALL DETAILS
A8.2	CEILING DETAILS
A8.3	MISC. DETAILS

ELECTRICAL

E000	ELECTRICAL SPECIFICATION
E001	SINGLE LINE DIAGRAM/ SCHEDULES
E100	ELECTRICAL PLAN
TE00	TITLE24 - INDOOR

MECHANICAL

M000	MECHANICAL NOTES
M001	MECHANICAL SCHEDULES AND DETAILS
M100	MECHANICAL PLAN
M101	MECHANICAL PLAN - ROOF PLAN
TM00	MECHANICAL TITLE 24 - 1

PLUMBING

P000	PLUMBING NOTES & SCHEDULES
P001	PLUMBING DETAILS & SPECIFICATION SHEETS
P100	PLUMBING PLAN
TP00	TITLE 24

STRUCTURAL

S2.0	EXISTING ROOF FRAMING PLAN
SD1	FRAMING DETAILS

SITE PLAN

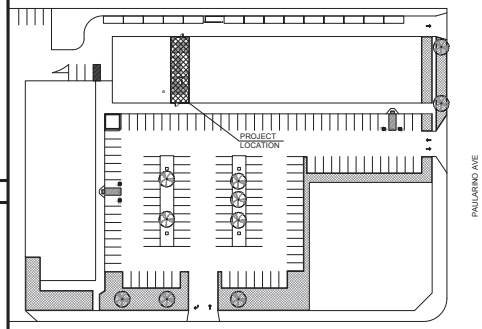

2 SITE MAP (FOR REFERENCE ONLY) SCALE: NTS

VICINITY MAP

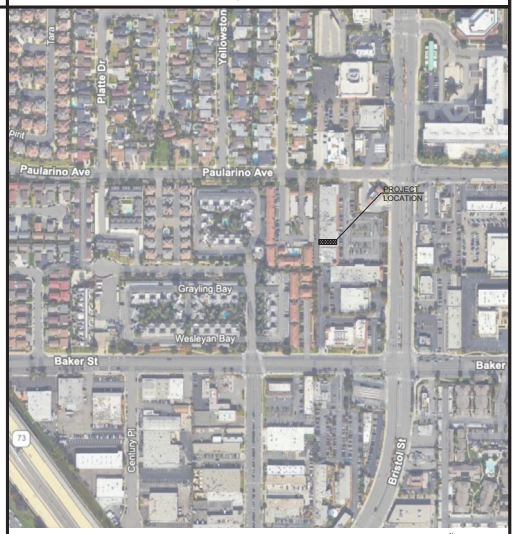

1 VICINITY MAP (FOR REFERENCE ONLY) SCALE: NTS

PROPOSED FLOOR PLAN

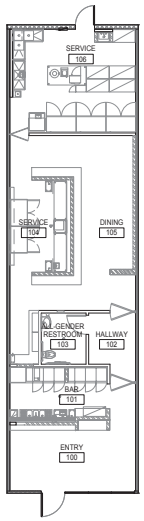

3 FLOOR PLAN (REFERENCE ONLY) SCALE: NTS

STRUCTURAL ENGINEER

KOOSHA ENGINEERING
26582 WHITE OAKS DR
LAGUNA HILLS CA 92653

FAHIM HAKEMI
949.945.9616 / KEINC.INFO@GMAIL.COM

MEP ENGINEER

CIRCA DOMINI INTERNATIONAL INC.
9890 RESEARCH DR SUITE 100
IRVINE, CA 92618

DAVID KANG
949.533.4117 / DKANG@CDIENG.COM

ABBREVIATIONS

#	Pound OR Number	DN	Down	HR	Hour	RBR	Rubber
&	And	DR	Door	HVAC	Heating, Ventilating, And Air Conditioning	RCP	Reflected Ceiling Plan
@	At	DWG	Drawing			RD	Roof Drain
ACT	Acoustic Ceiling Tile	EA	Each	IRGWB	Impact Resistant Gypsum Wall Board	REQD	Required
AD	Area Drain	EJ	Expansion Joint			RM	Room
AFF	Above Finished Floor	EL	Elevation	ILO	In Lieu Of	SIM	Similar
ALUM	Aluminum	ELEC	Electrical	INSUL	Insulated or Insulation	SPEC	Specified OR Specification
ANOD	Anodized	ELEV	Elevator or Elevation	INT	Interior	SPK	Sprinkler or Speaker
BSMT	Basement	EPDM	Ethylene Propylene Diene M-Class (Roofing)	LO	Low	SSTL	Stainless Steel
BYND	Beyond	EQ	Equal	MAX	Maximum	STC	Sound Transmission Coefficient
BOT	Bottom	EXIST	Existing	MO	Masonry Opening		
CIP	Cast In Place	EXP JT	Expansion Joint	MECH	Mechanical	STL	Steel
CHNL	Channel	EXT	Exterior	MEMBR	Membrane	STRUCT	Structure or Structural
CJ	Control Joint	FD	Floor Drain or Fire Department	MIN	Minimum	T&G	Tongue And Groove
CLG	Ceiling			MRGWB	Moisture-Resistant Gypsum Wall Board	TELE	Telephone
CLR	Clear	FEC	Fire Extinguisher Cabinet	MTL	Metal	TLT	Toilet
CMU	Concrete Masonry Unit	FIXT	Fixture	NIC	Not In Contract	TO	Top Of
COL	Column	FLR	Floor	NO	Number	TOC	Top Of Concrete
COMPR	Compressible	FM	Filled Metal	NOM	Nominal	TOS	Top Of Steel
CONC	Concrete	FO	Face Of	OC	On Center	TPD	Toilet Paper Dispenser
CONT	Continuous	FND	Foundation	OH	Opposite Hand	T/D	Telephone/Data
CPT	Carpet	GA	Gauge	OZ	Ounce	TYP	Typical
CT	Ceramic Tile	GALV	Galvanized	PCC	Pre-Cast Concrete	UNO	Unless Noted Otherwise
CTYD	Courtyard	GWB	Gypsum Wall Board	PLUMB	Plumbing	U/S	Underside
DBL	Double	HC	Hollow Core	PLYD	Plywood	VIF	Verify In Field
DEMO	Demolish or Demolition	HI	High	PT	Pressure Treated	VP	Vision Panel
DIA	Diameter	HM	Hollow Metal	PNT	Paint or Painted	W/	With
DIM	Dimension	HP	High Point	PVC	Polyvinyl Chloride	WD	Wood
DIMS	Dimensions						

SYMBOLS LEGEND

ALIGN

OFFICE 100 — ROOM NAME / ROOM NUMBER

NEW DOOR
DOOR NUMBER
(REF. TO DOOR SCHEDULE)

EXISTING DOOR

FIRE EXTINGUISHER CABINET W/ FIRE EXTINGUISHER

FE — WALL MOUNTED FIRE EXTINGUISHER

X — KEYNOTE INDICATOR

X — EQUIPMENT TAG

REVISION CLOUD & DELTA NUMBER

X / AX.X — DETAIL REFERENCE / SHEET NUMBER

X / AX.X — DETAIL SECTION / SHEET NUMBER

X / AX.X — SECTION REFERENCE / SHEET NUMBER

X / AX.X — ELEVATION REFERENCE / SHEET NUMBER

X — ELEVATION VIEW

X / AX.X — ELEVATION REFERENCE / SHEET NUMBER

X / X — WALL MATERIAL TYPE / TYPE NUMBER

X / X — FLOOR MATERIAL TYPE / TYPE NUMBER

X / X — MISC. MATERIAL TYPE / TYPE NUMBER

KingKong
DESIGN + CONSTRUCTION

www.KingKongDS.com
Irvine, California
info@kingkongds.com 949.466.3878

This document contains confidential information and is an instrument of professional services by King Kong Studio Inc. These documents are the property of King Kong Studio Inc. and shall not be reproduced or used without the written approval from King Kong Studio Inc.

All existing field dimensions and conditions are to be verified by the owner and/or contractors prior to starting construction. Any deviation or changes shall be notified to King Kong Studio Inc.

LICENSED ARCHITECT FRANCIS P. CHA No. C 18585 Exp. 3-31-27 STATE OF CALIFORNIA

PROJECT NAME: NAISHO OMAKASE

PROJECT LOCATION: 3033 BRISTOL ST, SUITE 117 COSTA MESA, CA 92626

STATUS / ACTION
drawn by: M.L.

DATE	ACTION ITEM
06.24.2025	PLAN REVIEW
07.09.2025	LL COMMENTS
08.26.2025	1ST CORRECTION
-	-
-	-
-	-
-	-
-	-
-	-
-	-
-	-
-	-
-	-
-	-

COVER SHEET

A0.1

EQUIPMENT SCHEDULE

	RM./ AREA	EQUIPMENT	MANUFACTURE	MODEL #	W x D x H	V / HZ / PH	DRAIN / WATER	BTU's	FINISH	NOTES
1	SERVICE 106	3-COMP SINK	REGENCY	600S31818XC	57" x 57" x 45"	N/A	DIRECT / -	-	S.S.	WITH SIDE SPLASH TO PREP SINK
2	SERVICE 106	3-COMP SINK FAUCET	FISHER	61077	-	N/A	- / YES	-	S.S.	WITH BACKFLOW PREVENTION
3	SERVICE 106	PREP SINK	REGENCY	600S18182X	54" x 24" x 45"	N/A	INDIRECT / -	-	S.S.	-
4	SERVICE 106	PREP SINK FAUCET	FISHER	60801	-	N/A	- / YES	-	S.S.	WITH BACKFLOW PREVENTION
5	SERVICE 106	MOP SINK	GSW	SE2024FM	20" x 24" x 14"	N/A	DIRECT / -	-	S.S.	-
6	SERVICE 106	MOP SINK FAUCET	FISHER	82530	-	N/A	- / YES	-	S.S.	WITH BACKFLOW PREVENTION
7	SERVICE 106 SERVICE 104	HANDSINK	REGENCY	600HS12SP	12" x 16" x 13"	N/A	DIRECT / YES	-	S.S.	WITH SPLASH GUARD
8	SERVICE 106	REACH-IN FRIDGE	TRUE	T-49-HC	55" x 30" x 79"	115/60/1	NO / NO	-	S.S.	QTY:2
9	SERVICE 106	REACH-IN FREEZER	TRUE	T-49F-HC	55" x 30" x 79"	115/60/1	NO / NO	-	S.S.	-
10	SERVICE 106	ICE BIN	MANITOWOC	D-570	30" x 34" x 50"	N/A	INDIRECT /NO	-	S.S.	-
11	SERVICE 106	ICE MACHINE	MANITOWOC	IT0500	30" x 24" x 22"	115/60/1	NO / YES	-	S.S.	ON EQUIPMENT #10
12	SERVICE 106	WORK TABLE	REGENCY	600TS3660S	60" x 36" x 34"	N/A	NO / NO	-	S.S.	
13	SERVICE 106	RICE COOKER	ZOJIRUSHI	NYC-36	18" x 16" x 14"	120/-/1	NO / NO	-	-	-
14	NOT USED									
15	NOT USED									
16	SERVICE 106	LOCKER	GSW	EL-5DR	12" x 20" x 77"	N/A	NO / NO	-	S.S.	-
17	SERVICE 104	WORK TABLE	REGENCY	600TS2472S	72" x 24" x 34"	N/A	NO / NO	-	S.S.	-
18	SERVICE 105	HOT WATER MACHINE	BUNN	43600.0040	8" x 19" x 29"	120/60/1	NO / YES	-	BLACK	-
19	SERVICE 106	WATER FILTER	EVERPURE	EV9328-06	30" x 7" x 26"	N/A	INDIRECT / YES	-	-	5 GPM
20	SERVICE 104	PREP SINK	REGENCY	60S1181818XL	39" x 24" x 44"	N/A	INDIRECT / YES	-	S.S.	LEFT DRAINBOARD
21	SERVICE 104	UNDERBAR HANDSINK	REGENCY	600UHS2112	12" x 21" x 33"	N/A	DIRECT / YES	-	S.S.	
22	SERVICE 104	UNDERCOUNTER FRIDGE	TRUE	TUC-48-HC	49" x 31" x 30"	115/60/1	NO / NO	-	S.S.	QTY:2
23	NOT USED									
24	NOT USED									
25	BAR 101	BACKBAR FRIDGE	TRUE	TBR72-RISZ1-L-B-SSS-1	59" x 28" x 40"	115/60/1	NO / NO	-	S.S.	QTY: 2 W/ 2" CASTERS
26	NOT USED									
27	BAR 101	UNDER BAR HANDSINK	REGENCY	600UHS1812KS	12" x 19" x 30"	N/A	DIRECT / YES	-	-	-
28	BAR 101	3-COMP SINK	REGENCY	600B31014213	60" x 19" x 33"	N/A	DIRECT / -	-	-	-
29	BAR 101	3-COMP SINK FAUCET	FISHER	61077	-	N/A	- / YES	-	-	WITH BACKFLOW PREVENTION
30	BAR 101	DRINK RAIL	AVANTCO	DRKR-	CUSTOM	N/A	INDIRECT / NO	-	-	COUNTERTOP LENGTH
31	BAR 101	UNDER BAR ICE BIN	REGENCY	600IB1824KIT	24" x 19" x 33"	N/A	INDIRECT / NO	-	-	-
32	BAR 101	GLASS RINSER	MICRO MATIC	GR-UCM	7" x 12" x 1"	N/A	INDIRECT / YES	-	-	-
33	NOT USED									
34	NOT USED									
35	SERVICE 106	STORAGE RACK	REGENCY	460EC2448K74	24" x 48" x 74"	N/A	NO / NO	-	S.S.	QTY:4
36	SERVICE 106	STORAGE RACK	REGENCY	460EC2436K74	24" x 36" x 74"	N/A	NO / NO	-	S.S.	QTY:1
37	SERVICE 104	HANDSINK FAUCET	REGENCY	600UHS2112	-	N/A	- / YES	-	S.S.	
38	SERVICE 104	WALL SHELF	REGENCY	600WS1248	48" x 12" x 2"	N/A	NO / NO	-	S.S.	-
39	SERVICE 106	WIRE SHELF	REGENCY	460EC1842	42" x 18" x 34"	N/A	NO / NO	-	S.S.	-
40	SERVICE 106	MOP RACK	REGENCY	600MBR24	24" x 5" x 5"	N/A	NO / NO	-	S.S.	-
41	SERVICE 104	DRYING RACK	REGENCY	600STR22KD	22" x 18" x 12"	N/A	NO / NO	-	S.S.	
42	SERVICE 106 SERVICE 105 BAR 101	SPLASH GUARD	GSW	SP-S2412	1" x 24" x 12"	N/A	NO / NO	-	S.S.	QTY:6
43	BAR 101	DUMP SINK	REGENCY	600B11014	15" x 19" x 33"	N/A	INDIRECT / YES	-	S.S.	-
44	SERVICE 106	AIR CURTAIN	BOLTIC	687BFM150PC	36" x 9" x 11"	120/60/1	NO / NO	-	S.S.	W/ DOOR ACTIVATE SWITCH

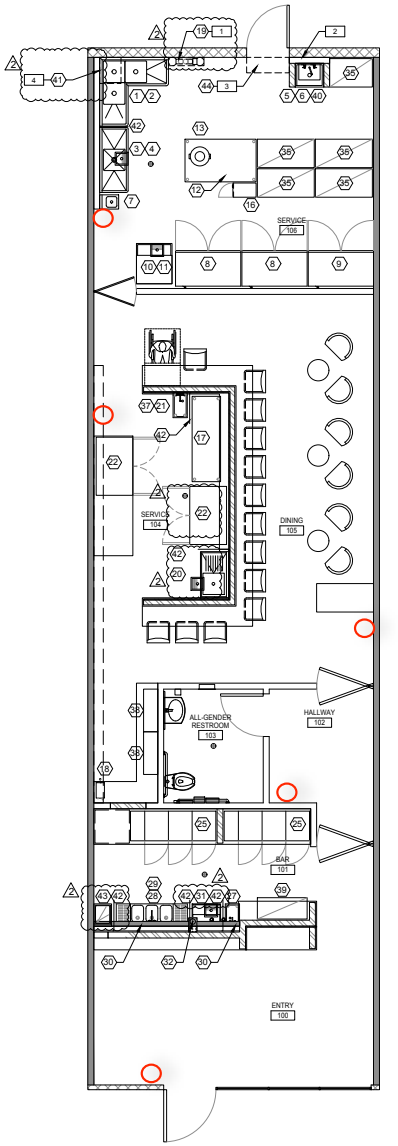

1 EQUIPMENT PLAN

SCALE 1/4" = 1'-0"

KEYNOTES

1. BOTTOM OF WATER FILTER IN THIS LOCATION TO BE MOUNTED AT 72" A.F.F.
2. WATER HEATER ABOVE MOP SINK IN THIS LOCATION. SEE PLUMBING DRAWING FOR SPECIFICATION.
3. REPLACE EXISTING AIR CURTAIN ABOVE DOOR IN THIS LOCATION
4. UTENSIL DRYING RACK TO BE AT 60" A.F.F. IN THIS LOCATION.

FIRE EXTNGUISHER

WALL LEGEND

- EXISTING GYP. BD. WALLS, MASONARY WALLS, AND/OR COLUMNS TO REMAIN.
- EXISTING INTERIOR WALL.
- NEW HALF WALL PARTITION - SEE KEYNOTE FOR HEIGHT. REFER TO WALL TYPE E ON 1/A8.1 (1 A8.1, 2 A8.1, 10 A8.1, 11 A8.1)
- NEW INTERIOR WALL FULL HEIGHT TO UNDERSIDE OF STRUCTURE ABOVE. REFER TO WALL TYPE D ON 1/A8.1 (1 A8.1, 2 A8.1, 3 A8.1, 11 A8.1)

KingKong
DESIGN + CONSTRUCTION
www.KingKongDS.com
Irvine, California
info@kingkongds.com 949.466.3878

This document contains confidential information and is an instrument of professional services by King Kong Studio Inc. These documents are the property of King Kong Studio Inc. and shall not be reproduced or used without the written approval from King Kong Studio Inc.

All existing field dimensions and conditions are to be verified by the owner and/or contractors prior to starting construction. Any deviation or changes shall be notified to King Kong Studio Inc.

LICENSED ARCHITECT FRANCIS P. GILES No. C 18585 Exp. 3-31-27 STATE OF CALIFORNIA

PROJECT NAME. NAISHO OMAKASE

PROJECT LOCATION. 3033 BRISTOL ST, SUITE 117 COSTA MESA, CA 92626

STATUS / ACTION

drawn by: M.L.

	DATE	ACTION ITEM
	06.24.2025	PLAN REVIEW
1	07.09.2025	LL COMMENTS
2	08.26.2025	1ST CORRECTION
	-	-
	-	-
	-	-
	-	-
	-	-
	-	-
	-	-
	-	-
	-	-
	-	-
	-	-
	-	-
	-	-
	-	-

EQUIPMENT PLAN

A3.2

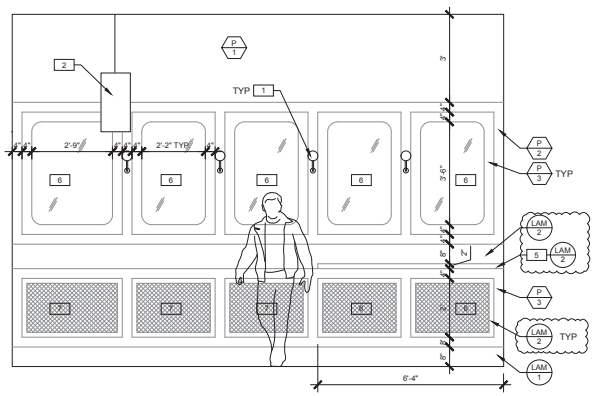

E ELEVATION - BAR 101

SCALE 1/2" = 1'-0"

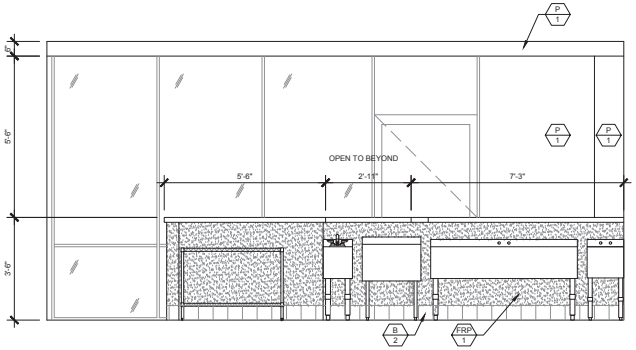

C ELEVATION - BAR 101

SCALE 1/2" = 1'-0"

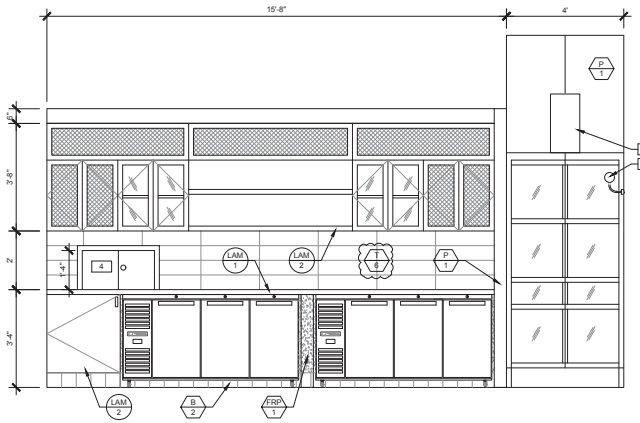

B ELEVATION - BAR 101

SCALE 1/2" = 1'-0"

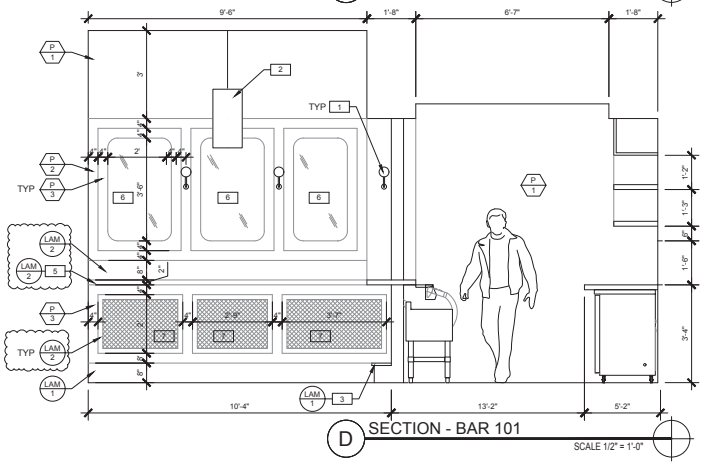

D SECTION - BAR 101

SCALE 1/2" = 1'-0"

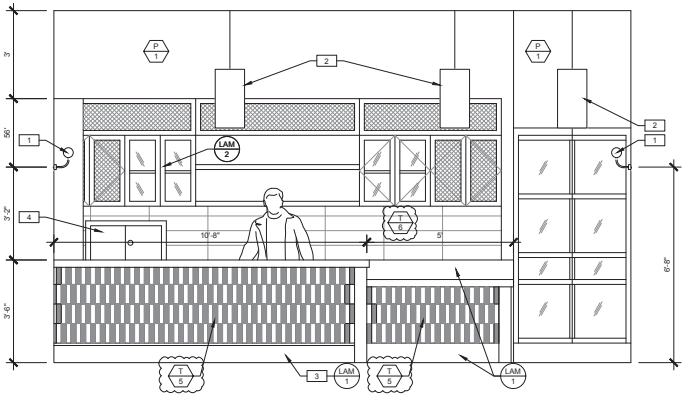

A ELEVATION - BAR 101

SCALE 1/2" = 1'-0"

KEYNOTES

1. WALL SCONCES TO BE MOUNTED AT 80" A.F.F., SEE A4.1 FOR SPECIFICATION..
2. PENDANT LIGHT TO BE IN THIS LOCATION AT 8'-0" A.F.F., SEE A4.1 FOR SPECIFICATION.
3. FOOT REST IN THIS LOCATION. SEE 6/A8.3 FOR DETAIL
4. 16" H PASS THRU WINDOW TO BE AT 40" A.F.F. IN THIS LOCATION.
5. PROVIDE 8" DEPTH DRINK RAIL IN THIS LOCATION.
6. TINTED ANTIQUE MIRROR WITH FRAME TO MATCH LAM-1 TO BE IN THIS LOCATION.
7. BRASS MESH SCREEN PANELS WITH FRAME TO BE STAINED TO MATCH LAM-2 TO BE IN THIS LOCATION.

FINISH LEGEND

WALL FINISHES

P 1 — ITEM: PAINT - ENTRY 100, BAR 101, SERVICE 104
MFR: DUNN EDWARDS
COLOR: DET641 / DORIC WHITE
FINISH: EGGSHELL

P 2 — ITEM: PAINT - ENTRY 100
MFR: DUNN EDWARDS
COLOR: DET629 / FADE TO BLACK
FINISH: EGGSHELL

P 3 — ITEM: PAINT - ENTRY 100
MFR: DUNN EDWARDS
COLOR: DET601 / CHARCOAL BRIQUETTE
FINISH: EGGSHELL

P 4 — ITEM: PAINT - HALLWAY 102
MFR: DUNN EDWARDS
COLOR: DET431 / COTTON CLUB
FINISH: EGGSHELL

P 5 — ITEM: PAINT - HALLWAY 102
MFR: DUNN EDWARDS
COLOR: DET433 / TIFFANY ROSE
FINISH: EGGSHELL

P 6 — ITEM: PAINT -SERVICE 104
MFR: DUNN EDWARDS
COLOR: DET625 / RECLAIMED WOOD
FINISH: EGGSHELL

P 7 — ITEM: PAINT - DINING 105
MFR: DUNN EDWARDS
COLOR: DET619 / CELLULOID
FINISH: EGGSHELL

T 1 — ITEM: WALL TILE - RESTROOM 103
MFR: BEDROSIANS
COLOR: DECCLOPINSBG / PINK
FINISH: GLOSS
SIZE: 2.5"X 5"

T 2 — ITEM: STONEWORK FLUTED - DINING 105
MFR: TILE BAR
COLOR: BOTTICINO
FINISH: 3D HONED
SIZE: 12X24

T 3 — ITEM: ALLORA RHOMBOID - SERVICE 104
MFR: BEDROSIANS
COLOR: SOLID BLACK - DECALLBLARHOM
FINISH: MATTE
SIZE: 7.5"X12.75" RHOMBUS

T 4 — ITEM: CURVE WALL TILE - SERVICE 104
MFR: ARIZONA TILE
COLOR: TAUPE - ATCURVETA
FINISH: MATTE GLAZED
SIZE: 8" X 8"

T 5 — ITEM: ALTOS NERO TILE - BAR 101
MFR: TILE BAR
COLOR: BLACK / WHITE
FINISH: POLISHED
SIZE: 10" X 22"

T 6 — ITEM: PREMIUM FLUTED - BAR 101, HALLWAY 102, RESTROOM 103
MFR: TILE BAR
COLOR: CALACATTA VIOLA
FINISH: HONED
SIZE: 6" X 24" FLUTED

B 1 — ITEM: WOOD WALL BASE - TYPICAL
MFR: CUSTOM
COLOR: MATCH WALL PAINT
FINISH: MATCH WALL PAINT
SIZE: 5" H

B 2 — ITEM: QUARRY COVE BASE - BAR 101,SERVICE 104,106
MFR: DALTILE
COLOR: ARID GRAY
FINISH: MATTE (SMOOTH)
SIZE: 6" X 6"

FRP 1 — ITEM: FIBERGLASS REINFORCED PANEL - BAR 101,SERVICE 104,106
MFR: MARLITE
COLOR: BRITE WHITE / P199
FINISH: PEBBLED
SIZE: 4' X 9'

FLOOR FINISHES

FT 1 — ITEM: VINYL FLOOR - ENTRY 100
MFR: LIOUS FLOOR
COLOR: LI-NE212 / MEDIEVAL
FINISH: UV ACRYLIC
SIZE: 60" X 9"

FT 2 — ITEM: QUARRY FLOOR TILE - BAR 101,SERVICE 104,106
MFR: DALTILE
COLOR: ARID GRAY
FINISH: MATTE (SMOOTH)
SIZE: 6" X 6"

FT 3 — ITEM: FLOOR TILE - RESTROOM 103
MFR: EMSER
COLOR: F13STERGR1224/ STERLINA GRAY
FINISH: MATTE
SIZE: 12" X 24"

FT 4 — ITEM: VINYL FLOOR TILE - HALLWAY 102
MFR: ARMSTRONG
COLOR: SC910 BLACK / SC899 WHITE
FINISH: MATTE
SIZE: 24" X 24"

CON 1 — ITEM: EPOXY CONCRETE SEALANT - DINING 105
MFR: CUSTOM
COLOR: CUSTOM
FINISH: CUSTOM
SIZE: CUSTOM

MISC. FINISHES

LAM 1 — ITEM: DECO METAL LAMINATE - ENTRY 100, BAR 101
MFR: FORMICA
COLOR: M6423-99
FINISH: BRUSHED BRASS

LAM 2 — ITEM: FREMONT OAK LAMINATE - ENTRY 100
MFR: WILSONART
COLOR: 8251K-79
FINISH: RIDGEWOOD

LAM 3 — ITEM: STANDARD LAMINATE - DINING 105
MFR: WILSONART
COLOR: 7987-38 PALISADE OAK
FINISH: FINE VELVET

LAM 4 — ITEM: DECORATIVE DOOR METAL LAMINATE - RESTROOM 103
MFR: WILSONART
COLOR: L6447-406
FINISH: BRUSHED AGED GOLD

TT 1 — ITEM: COVE SHAPE PROFILE - RESTROOM 103
MFR: SCHLUTER - DILEX-AHK
COLOR: AHK1S100TSCB
FINISH: BRONZE

WP 1 — ITEM: WALL PAPER - HALLWAY 102
MFR: PHOTOWALL
COLOR: PINK / BEIGE - E93675
FINISH: GRAND ARCHES PATTERN

KingKong
DESIGN + CONSTRUCTION
www.KingKongDS.com
Irvine, California
info@kingkongds.com 949.466.3878

This document contains confidential information and is an instrument of professional services by King Kong Studio Inc. These documents are the property of King Kong Studio Inc. and shall not be reproduced or used without the written approval from King Kong Studio Inc.

All existing field dimensions and conditions are to be verified by the owner and/or contractors prior to starting construction. Any deviation or changes shall be notified to King Kong Studio Inc.

LICENSED ARCHITECT
FRANCIS P. OKI
No. C 18585
Exp. 3-31-27
STATE OF CALIFORNIA

PROJECT NAME.
NAISHO OMAKASE

PROJECT LOCATION.
3033 BRISTOL ST, SUITE 117
COSTA MESA, CA 92626

STATUS / ACTION
drawn by: M.L.

DATE	ACTION ITEM
06.24.2025	PLAN REVIEW
07.09.2025	LL COMMENTS
08.26.2025	1ST CORRECTION
-	-
-	-
-	-
-	-
-	-
-	-
-	-
-	-
-	-
-	-
-	-
-	-

ELEVATIONS - BAR 101

A6.1

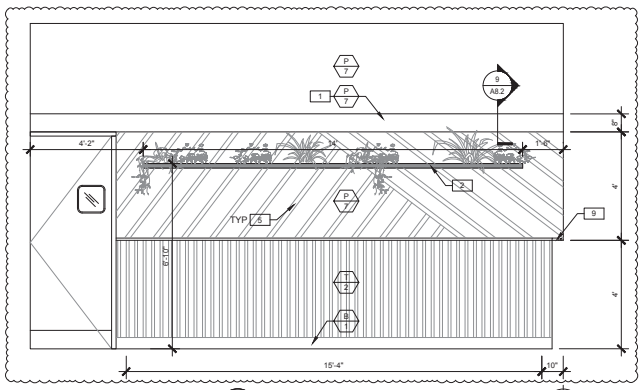

D ELEVATION - DINING 105
SCALE 1/2" = 1'-0"

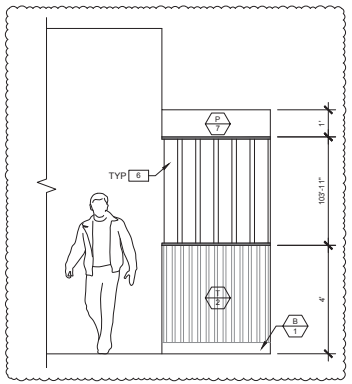

C ELEVATION - DINING 105
SCALE 1/2" = 1'-0"

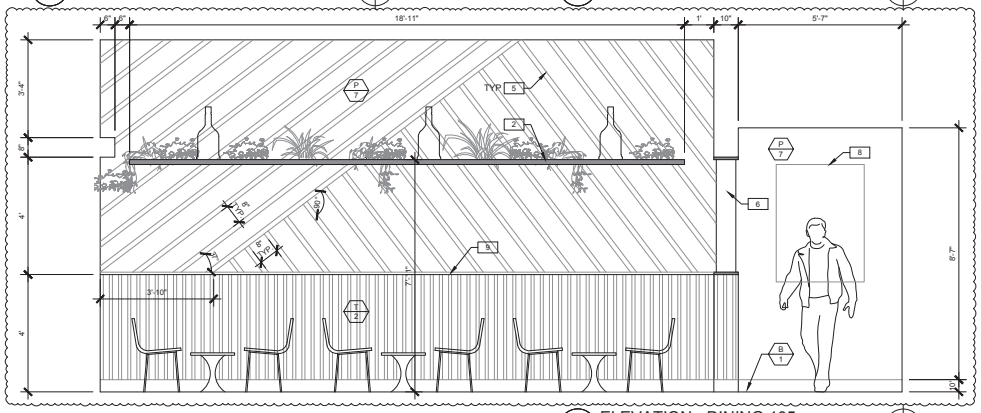

B ELEVATION - DINING 105
SCALE 1/2" = 1'-0"

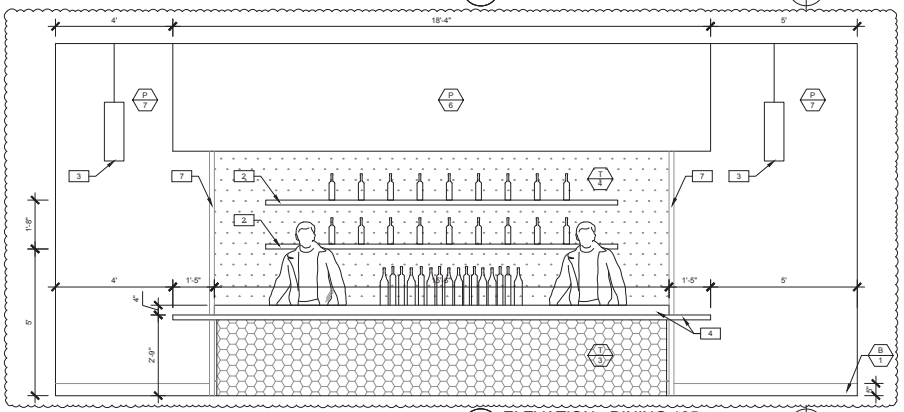

A ELEVATION - DINING 105
SCALE 1/2" = 1'-0"

FINISH LEGEND

WALL FINISHES

P 1 — ITEM: PAINT - ENTRY 100, BAR 101, SERVICE 104
MFR: DUNN EDWARDS
COLOR: DET641 / DORIC WHITE
FINISH: EGGSHELL

P 2 — ITEM: PAINT - ENTRY 100
MFR: DUNN EDWARDS
COLOR: DET629 / FADE TO BLACK
FINISH: EGGSHELL

P 3 — ITEM: PAINT - ENTRY 100
MFR: DUNN EDWARDS
COLOR: DET601 / CHARCOAL BRIQUETTE
FINISH: EGGSHELL

P 4 — ITEM: PAINT - HALLWAY 102
MFR: DUNN EDWARDS
COLOR: DET431 / COTTON CLUB
FINISH: EGGSHELL

P 5 — ITEM: PAINT - HALLWAY 102
MFR: DUNN EDWARDS
COLOR: DET433 / TIFFANY ROSE
FINISH: EGGSHELL

P 6 — ITEM: PAINT -SERVICE 104
MFR: DUNN EDWARDS
COLOR: DET625 / RECLAIMED WOOD
FINISH: EGGSHELL

P 7 — ITEM: PAINT - DINING 105
MFR: DUNN EDWARDS
COLOR: DET619 / CELLULOID
FINISH: EGGSHELL

T 1 — ITEM: WALL TILE - RESTROOM 103
MFR: BEDROSIANS
COLOR: DECCLOPIN2BG / PINK
FINISH: GLOSS
SIZE: 2.5" X 8"

T 2 — ITEM: STONEWORK FLUTED - DINING 105
MFR: TILE BAR
COLOR: BOTTICINO
FINISH: 3D HONED
SIZE: 12X24

T 3 — ITEM: ALLORA RHOMBOID - SERVICE 104
MFR: BEDROSIANS
COLOR: SOLID BLACK - DECALLBLARHOM
FINISH: MATTE
SIZE: 7.5"X12.75" RHOMBUS

T 4 — ITEM: CURVE WALL TILE - SERVICE 104
MFR: ARIZONA TILE
COLOR: TAUPE - ATCURVETA
FINISH: MATTE GLAZED
SIZE: 8" X 8"

T 5 — ITEM: ALTOS NERO TILE - BAR 101
MFR: TILE BAR
COLOR: BLACK / WHITE
FINISH: POLISHED
SIZE: 10" X 22"

T 6 — ITEM: PREMIUM FLUTED - BAR 101, HALLWAY 102, RESTROOM 103
MFR: TILE BAR
COLOR: CALACATTA VIOLA
FINISH: HONED
SIZE: 2" X 24" FLUTED

B 1 — ITEM: WOOD WALL BASE - TYPICAL
MFR: CUSTOM
COLOR: MATCH WALL PAINT
FINISH: MATCH WALL PAINT
SIZE: 5" H

B 2 — ITEM: QUARRY COVE BASE - BAR 101,SERVICE 104,106
MFR: DALTILE
COLOR: ARID GRAY
FINISH: MATTE (SMOOTH)
SIZE: 6" X 6"

FRP 1 — ITEM: FIBERGLASS REINFORCED PANEL - BAR 101,SERVICE 104,106
MFR: MARLITE
COLOR: BRITE WHITE / P199
FINISH: PEBBLED
SIZE: 4' X 9'

FLOOR FINISHES

FT 1 — ITEM: VINYL FLOOR - ENTRY 100
MFR: LIQUS FLOOR
COLOR: LINE212 / MEDIEVAL
FINISH: UV ACRYLIC
SIZE: 60" X 9"

FT 2 — ITEM: QUARRY FLOOR TILE - BAR 101,SERVICE 104,106
MFR: DALTILE
COLOR: ARID GRAY
FINISH: MATTE (SMOOTH)
SIZE: 6" X 6"

FT 3 — ITEM: FLOOR TILE - RESTROOM 103
MFR: EMSER
COLOR: F13STERGR1224/ STERLINA GRAY
FINISH: MATTE
SIZE: 12" X 24"

FT 4 — ITEM: VINYL FLOOR TILE - HALLWAY 102
MFR: ARMSTRONG
COLOR: SC910 BLACK / SC899 WHITE
FINISH: MATTE
SIZE: 12" X 12"

CON 1 — ITEM: EPOXY CONCRETE SEALANT - DINING 105
MFR: CUSTOM
COLOR: CUSTOM
FINISH: CUSTOM
SIZE: CUSTOM

MISC. FINISHES

LAM 1 — ITEM: DECO METAL LAMINATE - ENTRY 100, BAR 101
MFR: FORMICA
COLOR: M8423-99
FINISH: BRUSHED BRASS

LAM 2 — ITEM: FREMONT OAK LAMINATE - ENTRY 100
MFR: WILSONART
COLOR: 8251K-79
FINISH: RIDGEWOOD

LAM 3 — ITEM: STANDARD LAMINATE - DINING 105
MFR: WILSONART
COLOR: 7987-38 PALISADE OAK
FINISH: CAS VELVET

LAM 4 — ITEM: DECORATIVE DOOR METAL LAMINATE - RESTROOM 103
MFR: WILSONART
COLOR: L6447-40B
FINISH: BRUSHED AGED GOLD

TT 1 — ITEM: COVE SHAPE PROFILE - RESTROOM 103
MFR: SCHLUTER - DILEX-AHK
COLOR: AHK1S100TSOB
FINISH: BRONZE

WP 1 — ITEM: WALL PAPER - HALLWAY 102
MFR: PHOTOWALL
COLOR: PINK / BEIGE - E93675
FINISH: GRAND ARCHES PATTERN

KEYNOTES

1. EYEBROW SOFFIT TO BE AT 8'-0" A.F.F. IN THIS LOCAITON. SEE A4.1 FOR REFLECTED CEILING PLAN.
2. 8" DEPTH MILLWORK SHELF TO BE STAINED TO BLACK IN THIS LOCATION. CONTRACTOR TO PROVIDE SAMPLE TO BE APPROVED BY DESIGNER.
3. PENDANT LIGHT TO BE IN THIS LOCATION. SEE A4.1 FOR REFLECTED CEILING PLAN.
4. COUNTERTOP TO BE BUTCHER BLOCK WOOD MATERIAL IN THIS LOCATION.
5. 1" X1" DECORATIVE WOOD SLATS TO BE IN THIS LOCATION.
6. 1" X 10" WOOD SLATS TO BE STAINED TO MATCH LAM-3 TO BE INSTALLED AT 50° ANGLE IN THIS LOCATION. SEE A2.1 PARTITION PLAN FOR KEYNOTE.
7. SCHLUTER JOLLY TILE TRIM TO BE IN THIS LOCATION. CONTRACTOR TO PROVIDE SAMPLE TO BE APPROVED BY DESIGNER.
8. CLIENT PROVIDED ART WORK TO BE INSTALLED BY CONTRACTOR IN THIS LOCATION.
9. PROVIDE LOW VOLTAGE LED STRIP LIGHT ABOVE PARTIAL HEIGHT WALL IN THIS LOCATION. SEE 4/A8.3 FOR DETAIL

KingKong
DESIGN + CONSTRUCTION
www.KingKongDS.com
Irvine, California
info@kingkongds.com 949.466.3878

This document contains confidential information and is an instrument of professional services by King Kong Studio Inc. These documents are the property of King Kong Studio Inc. and shall not be reproduced or used without the written approval from King Kong Studio Inc.

All existing field dimensions and conditions are to be verified by the owner and/or contractors prior to starting construction. Any deviation or changes shall be notified to King Kong Studio Inc.

LICENSED ARCHITECT FRANCIS P. CHU No. C 18585 Exp. 3-31-27 STATE OF CALIFORNIA

PROJECT NAME: NAISHO OMAKASE

PROJECT LOCATION: 3033 BRISTOL ST, SUITE 117 COSTA MESA, CA 92626

STATUS / ACTION
drawn by: M.L.

DATE	ACTION ITEM
06.24.2025	PLAN REVIEW
07.09.2025	LL COMMENTS
08.26.2025	1ST CORRECTION
-	-
-	-
-	-
-	-
-	-
-	-
-	-
-	-
-	-
-	-
-	-
-	-

ELEVATIONS - DINING 105
A6.2

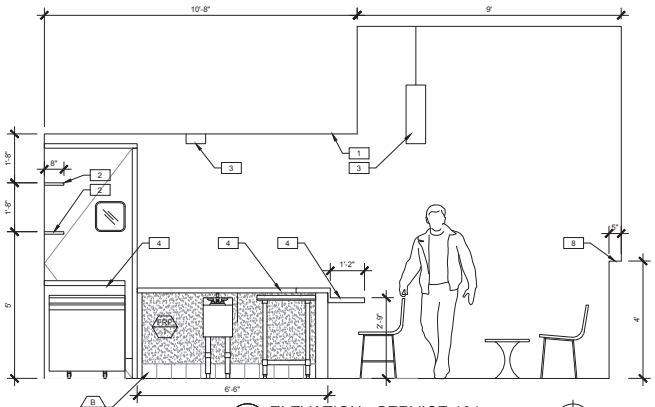

C ELEVATION - SERVICE 104

SCALE 1/2" = 1'-0"

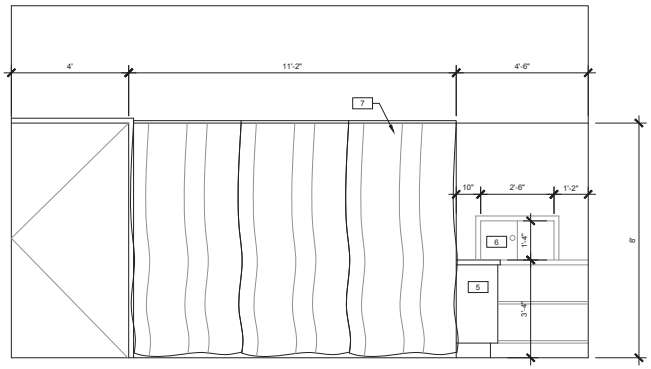

B ELEVATION - SERVICE 104

SCALE 1/2" = 1'-0"

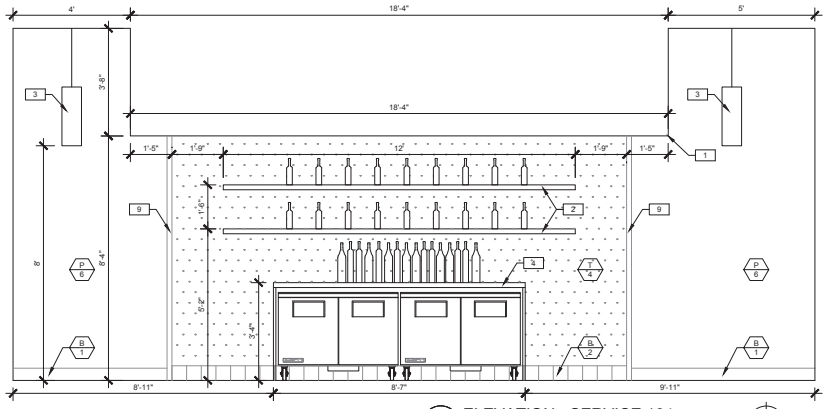

A ELEVATION - SERVICE 104

SCALE 1/2" = 1'-0"

FINISH LEGEND

WALL FINISHES

P 1 — ITEM: PAINT - ENTRY 100, BAR 101, SERVICE 104; MFR: DUNN EDWARDS; COLOR: DET641 / DORIC WHITE; FINISH: EGGSHELL

P 2 — ITEM: PAINT - ENTRY 100; MFR: DUNN EDWARDS; COLOR: DET629 / FADE TO BLACK; FINISH: EGGSHELL

P 3 — ITEM: PAINT - ENTRY 100; MFR: DUNN EDWARDS; COLOR: DET601 / CHARCOAL BRIQUETTE; FINISH: EGGSHELL

P 4 — ITEM: PAINT - HALLWAY 102; MFR: DUNN EDWARDS; COLOR: DET431 / COTTON CLUB; FINISH: EGGSHELL

P 5 — ITEM: PAINT - HALLWAY 102; MFR: DUNN EDWARDS; COLOR: DET433 / TIFFANY ROSE; FINISH: EGGSHELL

P 6 — ITEM: PAINT -SERVICE 104; MFR: DUNN EDWARDS; COLOR: DET625 / RECLAIMED WOOD; FINISH: EGGSHELL

P 7 — ITEM: PAINT - DINING 105; MFR: DUNN EDWARDS; COLOR: DET619 / CELLULOID; FINISH: EGGSHELL

T 1 — ITEM: WALL TILE - RESTROOM 103; MFR: BEDROSIANS; COLOR: DECCLOPIN28G / PINK; FINISH: GLOSS; SIZE: 2.5" X 8"

T 2 — ITEM: STONEWORK FLUTED - DINING 105; MFR: TILE BAR; COLOR: BOTTICINO; FINISH: 3D HONED; SIZE: 12X24

T 3 — ITEM: ALLORA RHOMBOID - SERVICE 104; MFR: BEDROSIANS; COLOR: SOLID BLACK - DECALLBLARHOM; FINISH: MATTE; SIZE: 7.5"X12.75" RHOMBUS

T 4 — ITEM: CURVE WALL TILE - SERVICE 104; MFR: ARIZONA TILE; COLOR: TAUPE - ATCURVETA; FINISH: MATTE GLAZED; SIZE: 8" X 8"

T 5 — ITEM: ALTOS NERO TILE - BAR 101; MFR: TILE BAR; COLOR: BLACK / WHITE; FINISH: POLISHED; SIZE: 10" X 22"

T 6 — ITEM: PREMIUM FLUTED - BAR 101, HALLWAY 102, RESTROOM 103; MFR: TILE BAR; COLOR: CALACATTA VIOLA; FINISH: HONED; SIZE: 6" X 24" FLUTED

B 1 — ITEM: WOOD WALL BASE - TYPICAL; MFR: CUSTOM; COLOR: MATCH WALL PAINT; FINISH: MATCH WALL PAINT; SIZE: 5" H

B 2 — ITEM: QUARRY COVE BASE - BAR 101,SERVICE 104,106; MFR: DALTILE; COLOR: ARID GRAY; FINISH: MATTE (SMOOTH); SIZE: 6" X 6"

FRP 1 — ITEM: FIBERGLASS REINFORCED PANEL - BAR 101,SERVICE 104,106; MFR: MARLITE; COLOR: BRITE WHITE / P199; FINISH: PEBBLED; SIZE: 4' X 9'

FLOOR FINISHES

FT 1 — ITEM: VINYL FLOOR - ENTRY 100; MFR: LIQUS FLOOR; COLOR: LI-NE212 / MEDIEVAL; FINISH: UV ACRYLIC; SIZE: 60" X 9"

FT 2 — ITEM: QUARRY FLOOR TILE - BAR 101,SERVICE 104,106; MFR: DALTILE; COLOR: ARID GRAY; FINISH: MATTE (SMOOTH); SIZE: 6" X 6"

FT 3 — ITEM: FLOOR TILE - RESTROOM 103; MFR: EMSER; COLOR: F13STERGR1224/ STERLINA GRAY; FINISH: MATTE; SIZE: 12" X 24"

FT 4 — ITEM: VINYL FLOOR TILE - HALLWAY 102; MFR: ARMSTRONG; COLOR: SC910 BLACK / SC899 WHITE; FINISH: MATTE; SIZE: 12" X 12"

CON 1 — ITEM: EPOXY CONCRETE SEALANT - DINING 105; MFR: CUSTOM; COLOR: CUSTOM; FINISH: CUSTOM; SIZE: CUSTOM

MISC. FINISHES

LAM 1 — ITEM: DECO METAL LAMINATE - ENTRY 100, BAR 101; MFR: FORMICA; COLOR: MS423-99; FINISH: BRUSHED BRASS

LAM 2 — ITEM: FREMONT OAK LAMINATE - ENTRY 100; MFR: WILSONART; COLOR: 8251K-79; FINISH: RIDGEWOOD

LAM 3 — ITEM: STANDARD LAMINATE - DINING 105; MFR: WILSONART; COLOR: 7987-38 PALISADE OAK; FINISH: FINE VELVET

LAM 4 — ITEM: DECORATIVE DOOR METAL LAMINATE - RESTROOM 103; MFR: WILSONART; COLOR: L6447-40S; FINISH: BRUSHED AGED GOLD

TT 1 — ITEM: COVE SHAPE PROFILE - RESTROOM 103; MFR: SCHLUTER - DILEX-AHK; COLOR: AHK1S100TSOB; FINISH: BRONZE

WP 1 — ITEM: WALL PAPER - HALLWAY 102; MFR: PHOTOWALL; COLOR: PINK / BEIGE - E93675; FINISH: GRAND ARCHES PATTERN

KEYNOTES

1. CEILING SOFFIT AT 8'-4" A.F.F. AT THIS LOCATION. SEE A4.1 FOR REFLECTED CEILING PLAN.
2. 8" DEPTH MILLWORK SHELF TO BE STAINED TO BLACK TO BE IN THIS LOCATION. CONTRACTOR TO PROVIDE SAMPLE TO BE APPROVED BY DESIGNER.
3. PENDANT LIGHT TO BE IN THIS LOCATION. SEE A4.1 FOR REFLECTED CEILING PLAN.
4. COUNTERTOP TO BE BUTCHER BLOCK WOOD MATERIAL IN THIS LOCATION.
5. STAINLESS STEEL MILLWORK TO BE IN THIS LOCATION. SEE 2/A6.4 FOR MILLWORK DRAWING.
6. 2'-6"W x 1'-4"H PASS-THRU WINDOW AT 40" A.F.F. TO BE IN THIS LOCATION.
7. CONTRACTOR TO PROVIDED HEAVY WEIGHT BLACK VELVET CURTAIN ON A STRAIGHT SURFACE MOUNTED ROUND BLACK CURTAIN ROD. VELVET MATERIAL TO BE SUBMITTED FOR REVIEW AND APPROVED BY DESIGNER PRIOR TO PROCURING.
8. PROVIDE LOW VOLTAGE LED STRIP LIGHT ABOVE PARTIAL HEIGHT WALL IN THIS LOCATION. SEE 4/A8.3 FOR DETAIL
9. SCHLUTER JOLLY TILE TRIM TO BE IN THIS LOCATION. CONTRACTOR TO PROVIDE SAMPLE TO BE APPROVED BY DESIGNER.

KingKong
DESIGN + CONSTRUCTION
www.KingKongDS.com
Irvine, California
info@kingkongds.com 949.466.3878

This document contains confidential information and is an instrument of professional services by King Kong Studio Inc. These documents are the property of King Kong Studio Inc. and shall not be reproduced or used without the written approval from King Kong Studio Inc.

All existing field dimensions and conditions are to be verified by the owner and/or contractors prior to starting construction. Any deviation or changes shall be notified to King Kong Studio Inc.

LICENSED ARCHITECT FRANCIS P. CHO No. C 18585 Exp. 3-31-27 STATE OF CALIFORNIA

PROJECT NAME: NAISHO OMAKASE

PROJECT LOCATION: 3033 BRISTOL ST, SUITE 117 COSTA MESA, CA 92626

STATUS / ACTION

drawn by: M.L.

DATE	ACTION ITEM
06.24.2025	PLAN REVIEW
07.09.2025	LL COMMENTS
08.26.2025	1ST CORRECTION
-	-
-	-
-	-
-	-
-	-
-	-
-	-
-	-
-	-
-	-
-	-
-	-
-	-

ELEVATIONS - SERVICE 104

A6.3